


Program (areas in SF)

Program	Units	Actual (SF)
Student	5.0	3,835.0

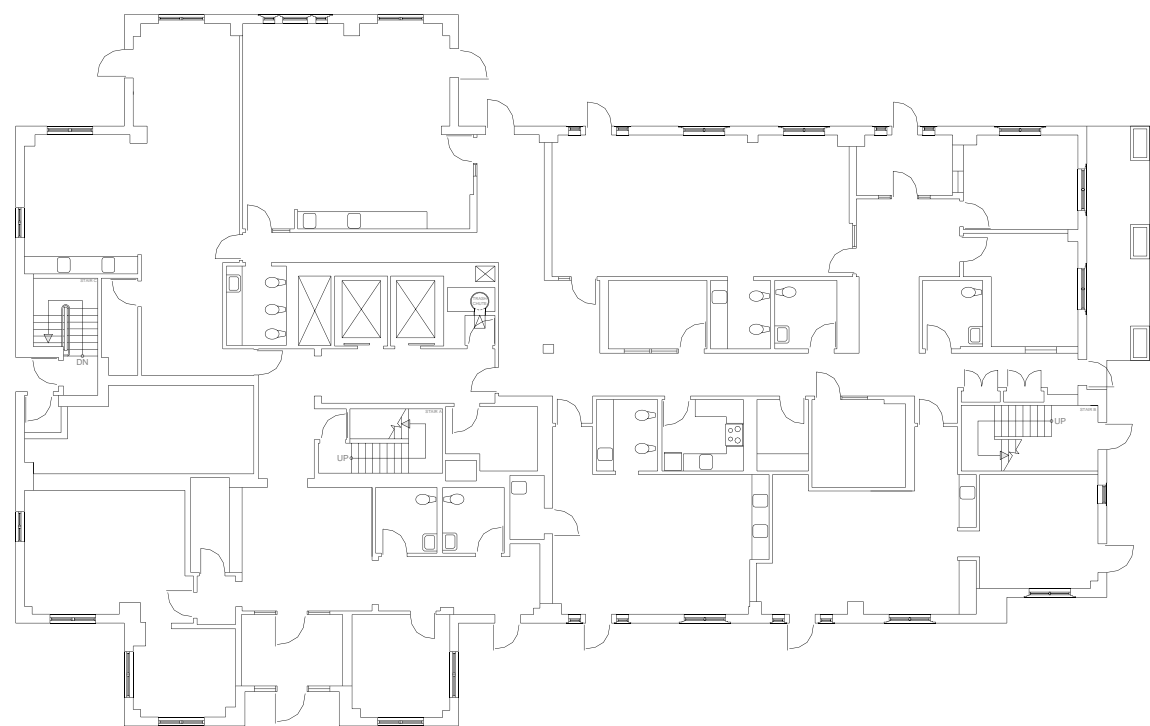


KEY PLAN
NOT TO SCALE

30	AP	AP	AP
31	DEWOLFE STREET_10-20		
32	FLOOR NAME (F): FIRST FLOOR (01)		
BLDG #:		06134	
DATE LAST CHECKED IN:		11/21/2017	

0 2' 4' 8' 16'

SCALE: UNITS: FEET

DeWolfe Street_10-20
10-20 Dewolfe Street Cambridge MA 02138
First
As Built
Mar 31, 2022

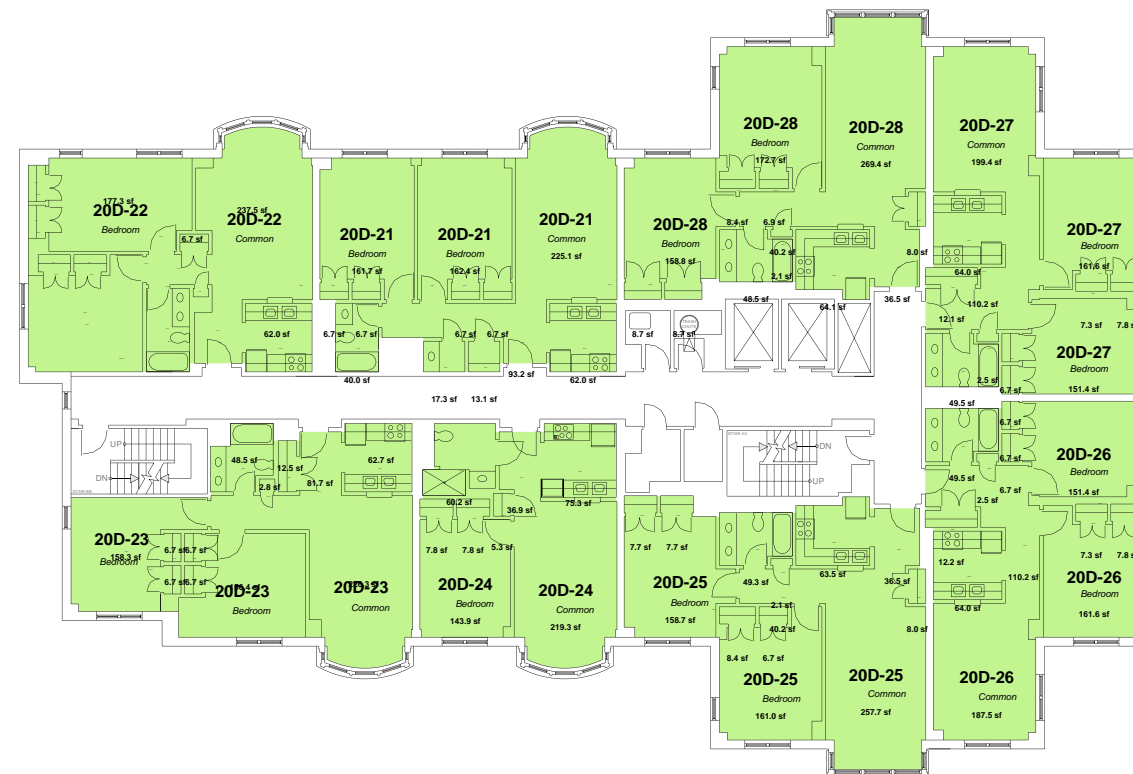

KEY PLAN
NOT TO SCALE

BUILDING NAME:
DEWOLFE STREET_10-20

FLOOR NAME (if):
SECOND FLOOR (02)

BLDG #:
06134

DATE LAST CHECKED IN:
11/21/2017

0 2' 4' 8' 16'
SCALE: CIVILS FEET

Program (areas in SF)	Units	Actual (SF)
Staff	1.0	824.6
Student	14.0	11,370.3
StudentGroup	1.0	848.3
TOTALS	16.0	13,043.2

DeWolfe Street_10-20
10-20 Dewolfe Street Cambridge MA 02138
Second
As Built
Mar 31, 2022



KEY PLAN
NOT TO SCALE

BUILDING NAME:
DEWOLFE STREET_10-20


FLOOR NAME (F):
THIRD FLOOR (03)

BLDG #:
06134

DATE LAST CHECKED IN:
11/21/2017

Program (areas in SF)		
	Units	Actual (SF)
Student	16.0	13,024.6
TOTALS	16.0	13,024.6

DeWolfe Street_10-20
10-20 Dewolfe Street Cambridge MA 02138
Third
As Built
Mar 31, 2022

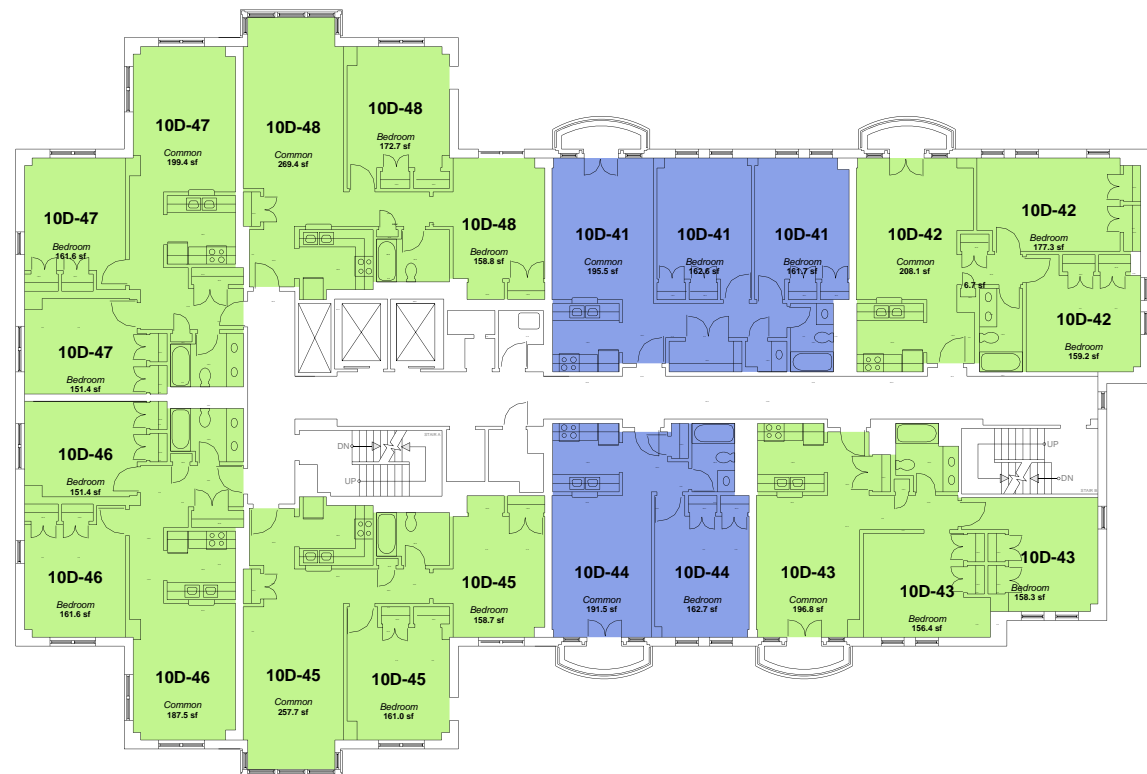

KEY PLAN NOT TO SCALE

BUILDING NAME:
DEWOLFE STREET_10-20

FLOOR NAME (if):
FOURTH FLOOR (04)

BLDG #:
06134

DATE LAST CHECKED IN:
11/21/2017

0 2' 4' 8' 16'

SCALE: UNITS: FEET

Program (areas in SF)

Program	Units	Actual (SF)
Student	14.0	11,366.5
Tutor	2.0	1,394.2

DeWolfe Street_10-20
10-20 Dewolfe Street Cambridge MA 02138
Fourth
As Built
Mar 31, 2022



KEY PLAN NOT TO SCALE

BUILDING NAME:
DEWOLFE STREET_10-20

FLOOR NAME (F):
FIFTH FLOOR (05)

BLDG #:
06134

DATE LAST CHECKED IN:
11/21/2017


0 2' 4' 8' 16'

SCALE: 1/8" = 1'-0"

Program (areas in SF)

Program	Units	Actual (SF)
Student	15.0	12,204.2
Tutor	1.0	552.9

DeWolfe Street_10-20
10-20 Dewolfe Street Cambridge MA 02138
Fifth
As Built
Mar 31, 2022

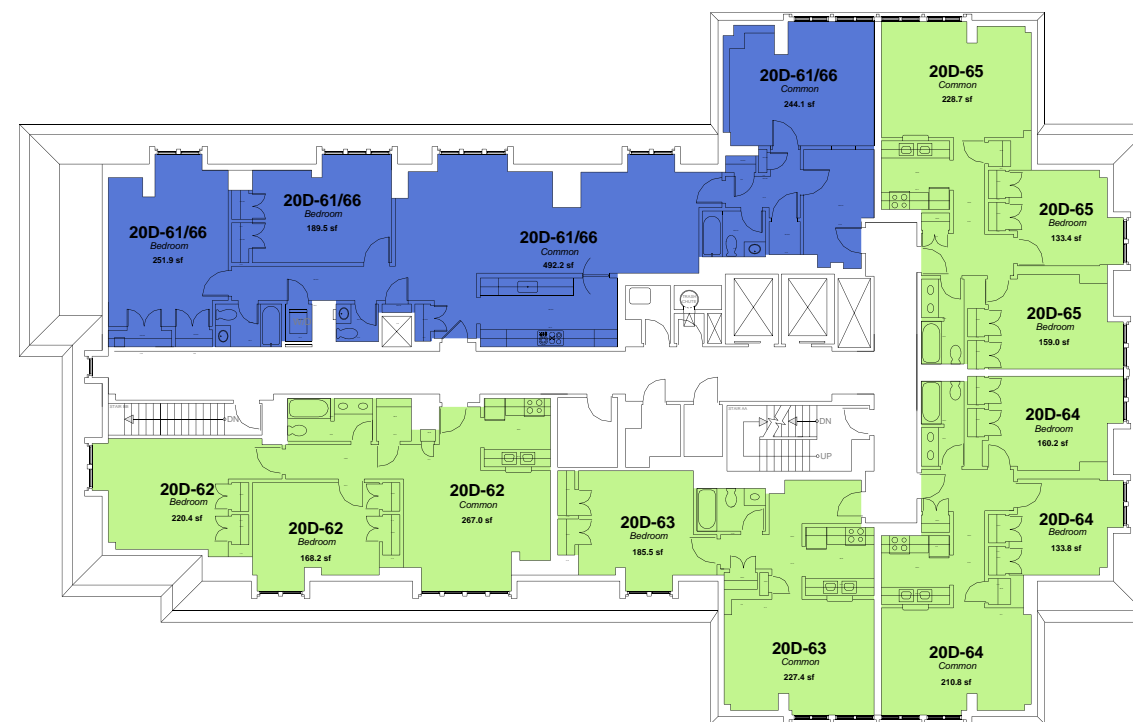

KEY PLAN
NOT TO SCALE

BUILDING NAME:
DEWOLFE STREET_10-20

FLOOR NAME (IF):
SIXTH FLOOR (06)

BLDG #:
06134

DATE LAST CHECKED IN:
11/27/2017

Program (areas in SF)	Units	Actual (SF)
Faculty Dean Asst	1.0	1,799.7
Student	8.0	7,727.3
Tutor	1.0	708.6

DeWolfe Street_10-20
10-20 Dewolfe Street Cambridge MA 02138
Sixth
As Built
Mar 31, 2022